1st and Final Bill

M. A. R. 57 (Rule 116) **No. D**

Measurement Book

Improvements to drains 4th, 5th cross & Bheveneshwaranagara at 60723

~~Serial~~ No. Bagalagunte in Ward No. 14.

Name of work ..... From ..... To .....

Name of Contractor of nature of Agency..... M/s. Sri Venkateshwara Enterprises.

Date of commencement of work.....

Date	Full description, etc, of work	Dimensions				Contents	Reference to last Measurement
		Number	Length	Breadth	Depth		
1	2	3	4	5	6	7	8
	Estimated cost :- 50.00 lakhs			Pcode - 3336			
	Job code :- 014-18-000013						
	AS NO:- EE/DD/AS/75/17-18. Dt. 01/09/2017 —						
	TS. NO:- EE/DD/TS/183/17-18- Dt 25/09/2017 —						
	W.O. NO:- EE/DD/WO/189/17-18- Dt. 11/01/18 —						
(1)	Earthwork excavation by manual means in ordinary soil involving an average horizontal throw upto 20m, and an average lift upto 0.30m. excavated surface						

S.A. — DR

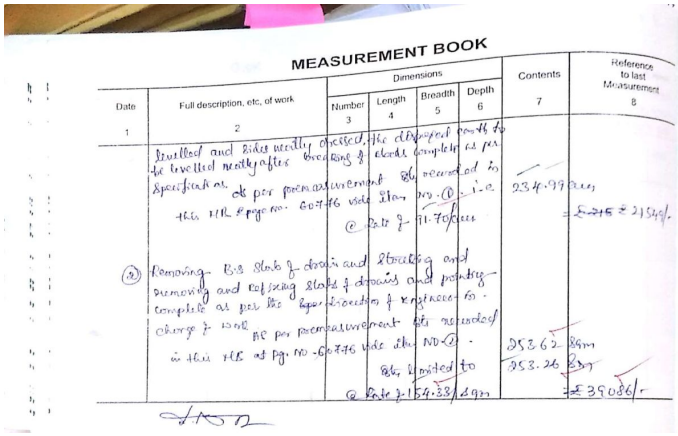

MEASUREMENT BOOK

Date	Full description, etc., of work	Dimensions: Number	Length	Breadth	Depth	Contents	Reference to last Measurement
1	2	3	4	5	6	7	8
	Levelled and dressed neatly & excised the different roads to be levelled neatly after breaking & clearing complete as per specification as per measurement & recorded in this MB at page no. 60776 vide item no. (1) i.e. @ Rate ₹ 71.70/sqm					234.99 sqm = ~~₹ 215~~ ₹ 2154/-	
(2)	Removing C.S. slab & drain and stacking and removing and refixing slabs & drains and painting complete as per the spec. direction & engineer in charge & cost as per measurement & recorded in this MB at pg. no. 60776 vide item no. (2) - @ Rate ₹ 154.33/sqm					353.62 sqm 353.26 ₹ 39086/-	

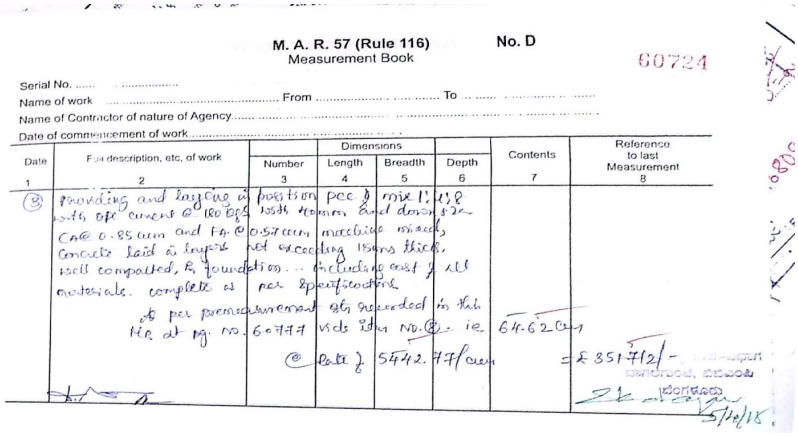

M. A. R. 57 (Rule 116) No. D
Measurement Book
60724

Serial No. .....
Name of work ..... From ..... To .....
Name of Contractor of nature of Agency .....
Date of commencement of work .....

Date	Full description, etc., of work	Dimensions: Number	Length	Breadth	Depth	Contents	Reference to last Measurement
1	2	3	4	5	6	7	8
(2)	Providing and laying in position pcc 1 mix 1:4:8 with 40mm nom. size graded stone aggregate @ 180 kg/cum and FA @ 0.57 cum machine mixed, Concrete laid in layers not exceeding 150mm thick, well compacted, R foundation ... including cost of all materials complete as per specification. as per measurement & recorded in this MB at pg. no. 60777 vide item no. (2) - ie @ Rate ₹ 5442.77/cum					64.62 cum = ₹ 351712/-	

Scanned by CamScanner

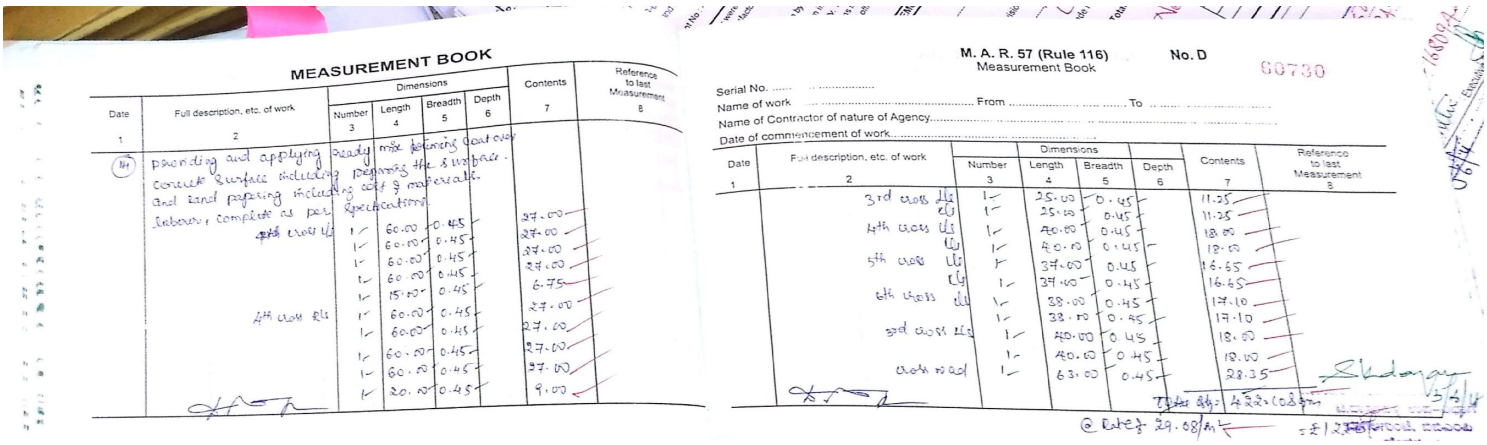

MEASUREMENT BOOK

Date	Full description, etc. of work	Dimensions: Number	Length	Breadth	Depth	Contents	Reference to last Measurement
1	2	3	4	5	6	7	8
14	providing and applying ready mix plastering coat over concrete surface including repairing the surface. And sand papering including cost & materials. Labours, complete as per specifications						
	4th wall Lt	1	60.00	0.45		27.00	
		1	60.00	0.45		27.00	
		1	60.00	0.45		27.00	
		1	60.00	0.45		6.75	
		1	15.00	0.45		27.00	
	4th wall Rt	1	60.00	0.45		27.00	
		1	60.00	0.45		27.00	
		1	60.00	0.45		27.00	
		1	60.00	0.45		27.00	
		1	20.00	0.45		9.00	

M. A. R. 57 (Rule 116) No. D
Measurement Book
60730

Serial No. .....
Name of work ..... From ..... To .....
Name of Contractor of nature of Agency.....
Date of commencement of work.....

Date	Full description, etc. of work	Dimensions: Number	Length	Breadth	Depth	Contents	Reference to last Measurement
1	2	3	4	5	6	7	8
	3rd wall Lt	1	25.00	0.45		11.25	
	Rt	1	25.00	0.45		11.25	
	4th wall Lt	1	40.00	0.45		18.00	
	Rt	1	40.00	0.45		18.00	
	5th wall Lt	1	37.00	0.45		16.65	
	Rt	1	37.00	0.45		16.65	
	6th wall Lt	1	38.00	0.45		17.10	
		1	38.00	0.45		17.10	
	3rd wall Lt	1	40.00	0.45		18.00	
		1	40.00	0.45		18.00	
	wall road	1	63.00	0.45		28.35	
					Total Qty:	422.00	

@ Rate @ 29.08/sq.m = £12,[illegible]

Scanned by CamScanner

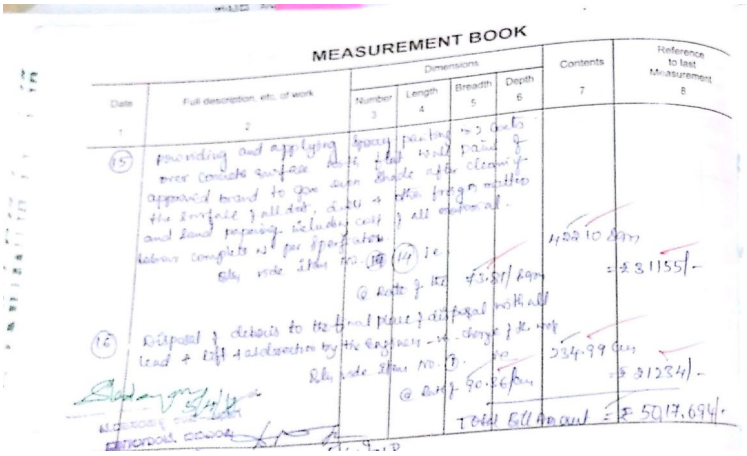

MEASUREMENT BOOK

Date	Full description, etc. of work	Dimensions: Number	Length	Breadth	Depth	Contents	Reference to last Measurement
1	2	3	4	5	6	7	8
						Total Bill Amount = ₹ 5017.694/-	

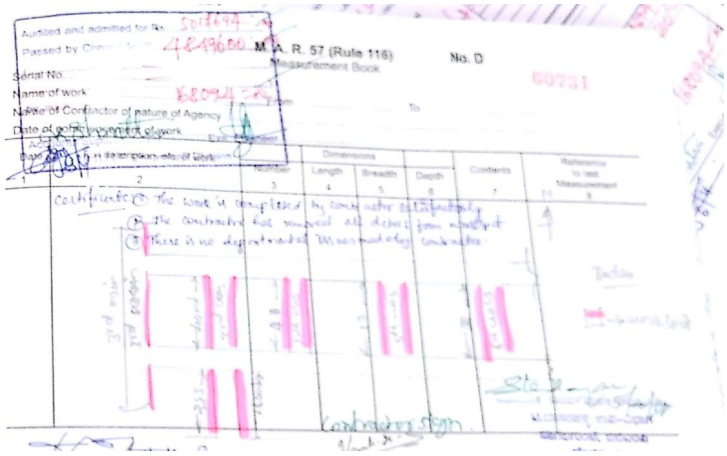

Audited and admitted for Rs. 5017.694/-
Passed by Chief Engineer for Rs. 4449.600 M.A. R. 57 (Rule 116) No. D
Measurement Book
Serial No.
Name of work
Name of Contractor or nature of Agency
Date of commencement of work
Date of completion of work

Date	Full description, etc. of work	Dimensions: Number	Length	Breadth	Depth	Contents	Reference to last Measurement
1	2	3	4	5	6	7	8

Certificate (1) The work is completed by contractor satisfactorily
(2) the contractor has removed all debris from site/unit
(3) There is no dispute related to the work executed by the contractor

Scanned by CamScanner